



DATUM=91.00				
ELEVATION	92.13	92.24	92.16 92.08	91.71
OFFSET	-8.97	-5.41	0.00 0.10	1.14

SECTION 1

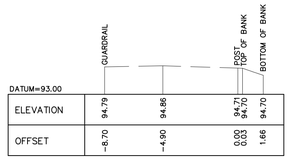


DATUM=93.00				
ELEVATION	94.79	94.86	94.71 94.70	94.70
OFFSET	-8.70	-4.90	0.00 0.03	1.66

SECTION 2

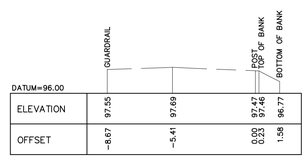


DATUM=96.00				
ELEVATION	97.55	97.69	97.47 97.46	96.77
OFFSET	-8.67	-5.41	0.00 0.23	1.58

SECTION 3

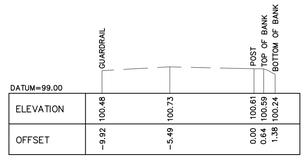


DATUM=99.00				
ELEVATION	100.48	100.73	100.61 100.59	100.24
OFFSET	-9.92	-5.49	0.00 0.64	1.38

SECTION 4

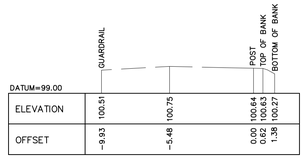


DATUM=99.00				
ELEVATION	100.51	100.75	100.64 100.63	100.27
OFFSET	-9.93	-5.48	0.00 0.62	1.38

SECTION 5

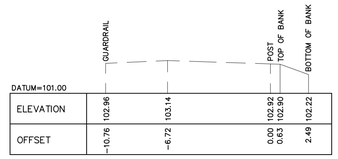

DATUM=101.00				
ELEVATION	102.96	103.14	102.92 102.90	102.22
OFFSET	-10.76	-6.72	0.00 0.63	2.49

SECTION 6

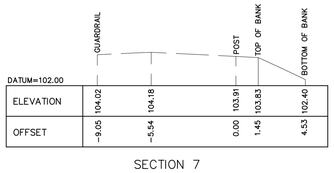


DATUM=102.00				
ELEVATION	104.02	104.18	103.91	103.83	102.40
OFFSET	-9.05	-5.54	0.00	1.45	4.53

SECTION 7




DATUM=102.00				
ELEVATION	104.12	104.14	103.85 103.82	102.47
OFFSET	-8.87	-4.90	0.00 0.10	3.68

SECTION 8

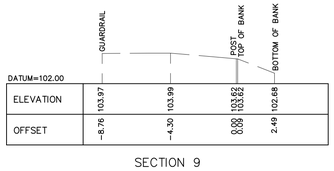

DATUM=102.00				
ELEVATION	103.97	103.99	103.62 103.62	102.68
OFFSET	-8.76	-4.30	0.00 0.09	2.49

SECTION 9

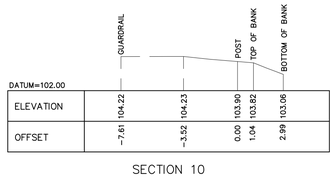

DATUM=102.00				
ELEVATION	104.22	104.23	103.90	103.82	103.06
OFFSET	-7.61	-3.52	0.00	1.04	2.99

SECTION 10




DATUM=103.00				
ELEVATION	104.83	104.90	104.59 104.56	103.97
OFFSET	-7.70	-4.04	0.00 0.41	2.61

SECTION 11




DATUM=105.00				
ELEVATION	106.56	106.59	106.39 106.37	105.83
OFFSET	-7.76	-4.11	0.00 0.06	2.16

SECTION 12

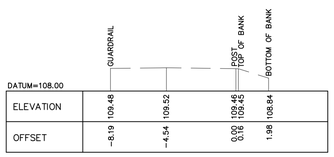


DATUM=108.00				
ELEVATION	109.48	109.52	109.46 109.45	108.84
OFFSET	-8.19	-4.54	0.00 0.18	1.98

SECTION 13

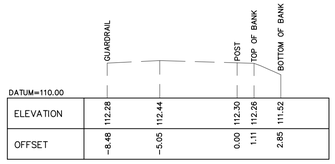


DATUM=110.00				
ELEVATION	112.28	112.44	112.30	112.26	111.52
OFFSET	-8.48	-5.05	0.00	1.11	2.85

SECTION 14

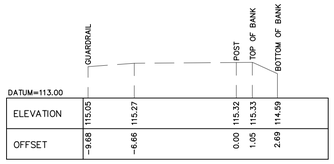


DATUM=113.00				
ELEVATION	115.05	115.27	115.32	115.33	114.59
OFFSET	-9.68	-6.66	0.00	1.05	2.69

SECTION 15

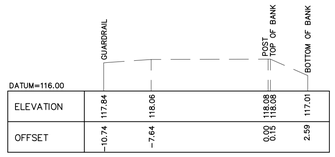


DATUM=116.00				
ELEVATION	117.84	118.06	118.08 118.08	117.01
OFFSET	-10.74	-7.64	0.00 0.13	2.59

SECTION 16

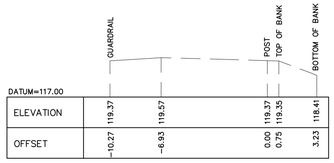


DATUM=117.00				
ELEVATION	119.37	119.57	119.37 119.35	118.41
OFFSET	-10.27	-6.93	0.00 0.75	3.23

SECTION 17

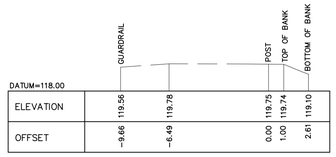


DATUM=118.00				
ELEVATION	119.56	119.78	119.75 119.74	119.10
OFFSET	-9.66	-6.49	0.00 1.00	2.61

SECTION 18

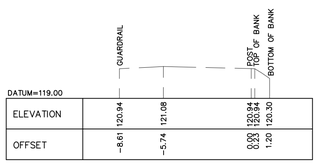


DATUM=119.00				
ELEVATION	120.94	121.08	120.94 120.94	120.30
OFFSET	-8.61	-5.74	0.00 0.23	1.20

SECTION 19

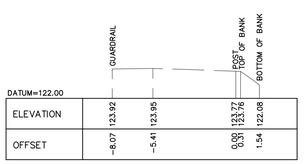


DATUM=122.00				
ELEVATION	123.92	123.95	123.77 123.76	122.08
OFFSET	-8.07	-5.41	0.00 0.31	1.54

SECTION 20

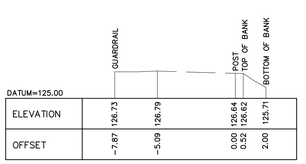


DATUM=125.00				
ELEVATION	126.73	126.79	126.64 126.62	125.71
OFFSET	-7.87	-5.09	0.00 0.52	2.00

SECTION 21

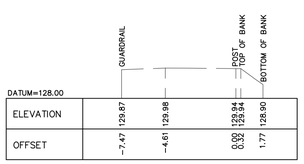


DATUM=128.00				
ELEVATION	129.87	129.98	129.84 129.84	128.90
OFFSET	-7.47	-4.61	0.00 0.52	1.77

SECTION 22

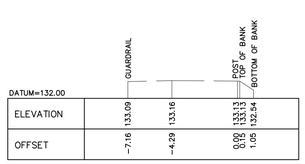


DATUM=132.00				
ELEVATION	133.09	133.16	133.13 133.13	132.54
OFFSET	-7.16	-4.29	0.00 0.15	1.05

SECTION 23

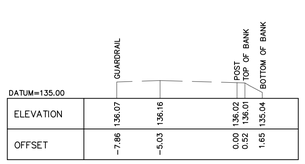


DATUM=135.00				
ELEVATION	136.07	136.16	136.02 136.01	135.04
OFFSET	-7.86	-5.03	0.00 0.52	1.65

SECTION 24

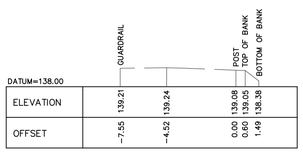


DATUM=138.00				
ELEVATION	139.21	139.24	139.08 139.05	138.38
OFFSET	-7.55	-4.52	0.00 0.60	1.49

SECTION 25

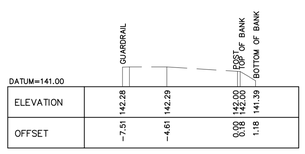

DATUM=141.00				
ELEVATION	142.28	142.29	142.00 142.00	141.39
OFFSET	-7.51	-4.61	0.00 0.18	1.18

SECTION 26

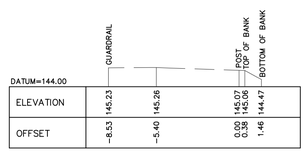

DATUM=144.00				
OFFSET	-8.53	-5.40	0.00 0.38	1.46

SECTION 27

NOTES

1. FOR CROSS SECTION LOCATIONS REFER TO DRAWING No. NS2011-014-02.

TOPOGRAPHICAL PLAN

CROSS SECTIONS
SIR ADAM BECK No.1
GLENN ACCESS ROAD
TOWN OF NIAGARA-ON-THE-LAKE
REGIONAL MUNICIPALITY OF NIAGARA

SCALE 1:200 METRIC
5m 0 5m 10m

THE LAROCQUE GROUP
O.L.S./PROJECT CONSULTANTS/LAND MANAGEMENT
12 LYMAN STREET, ST. CATHARINES, ONTARIO
905-688-1413
6385 COLBORNE STREET, NIAGARA FALLS, ONTARIO
905-358-8400
www.larocquegroup.ca

DATE : DEC. 27, 2012
FILE No. : NS2011-014
DWG.FILE : NS2011-014-04

mf roll number	rev no	date	particulars	dwn / chkd	appd

GLEN ACCESS ROAD
ROCK FALL PROTECTION
CROSS SECTIONS
OF FENCE

ONTARIO POWER GENERATION
Hydro-Thermal Operations
Niagara Plant Group

dwn: LG	designed by: LG	FOR ORIGINAL SIGNATURES SEE REVISION 00.
chkd: LG	design reviewed by: LG	
date: yr/month/day 2013.03.01	authorized by: LG	
scale: 1:200	CAD file type: DWG	

THIS DOCUMENT AND THE INFORMATION CONTAINED HEREIN IS THE EXCLUSIVE PROPERTY OF, AND IS CONFIDENTIAL AND PROPRIETARY TO, ONTARIO POWER GENERATION INC. ALL RIGHTS RESERVED. THIS DOCUMENT AND INFORMATION CONTAINED HEREIN MAY BE USED ONLY AS AUTHORIZED IN WRITING BY ONTARIO POWER GENERATION INC. AND MAY NOT BE REPRODUCED OR UTILIZED IN ANY FORM OR BY ANY MEANS, ELECTRONIC OR MECHANICAL, INCLUDING PHOTOCOPY, RECORDING, OR BY ANY INFORMATION STORAGE OR RETRIEVAL SYSTEM AND MAY NOT BE DISCLOSED, IN WHOLE OR IN PART, WITHOUT THE PRIOR WRITTEN CONSENT OF ONTARIO POWER GENERATION INC.

dwg no NF20-D1E-14100-0004 sht no 00 rev

CLASS No.

A1 (594 x 841)

0 10 50 100 200 250 300 millimetres