


Detail Fence Layout

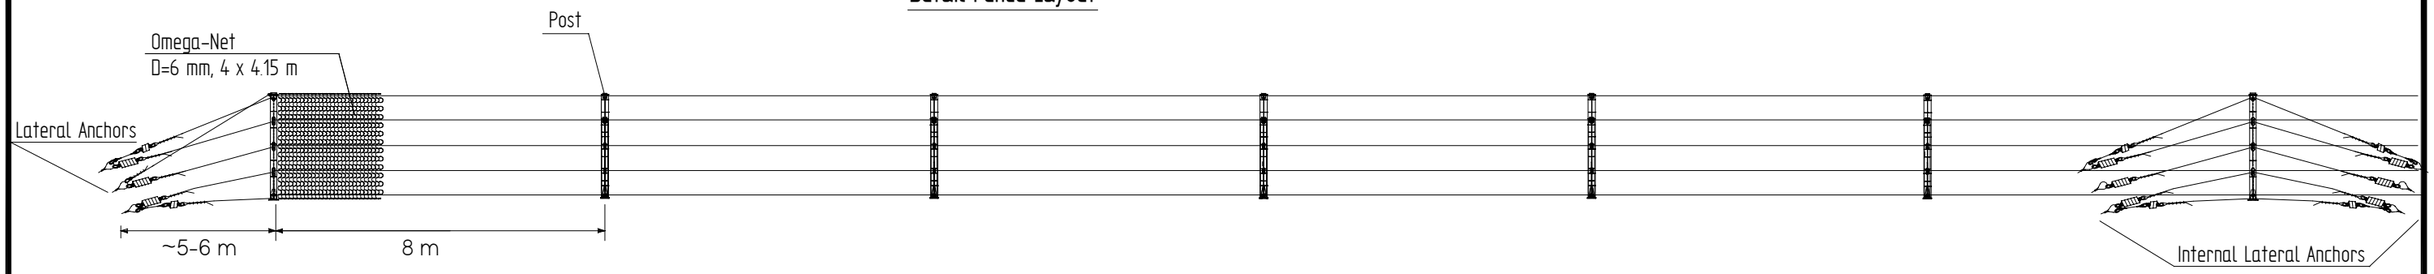


Detail Post

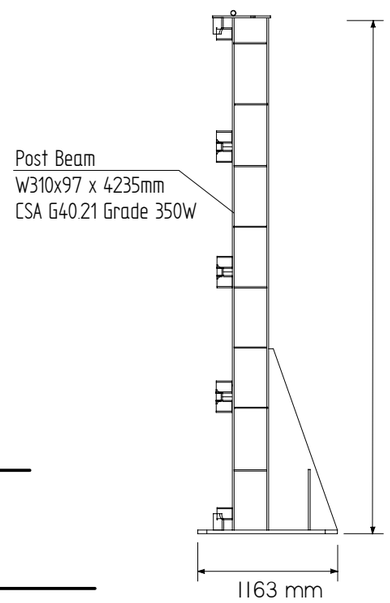


Detail Base Plate

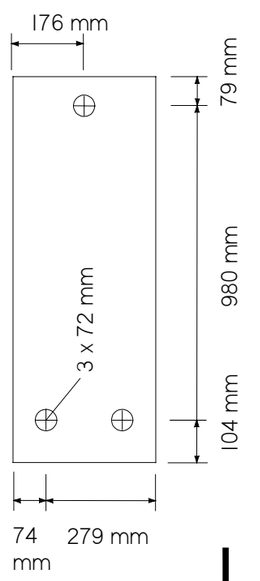

Detail Rope Guidance

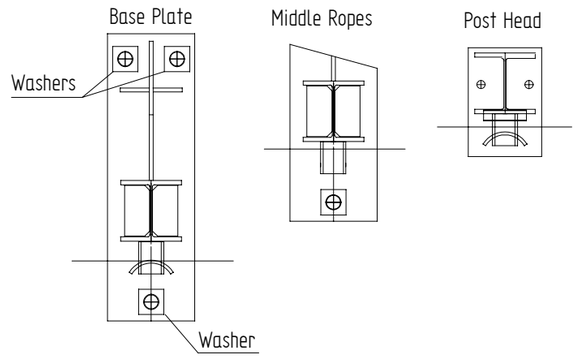

Detail Anchoring Rope Configuration

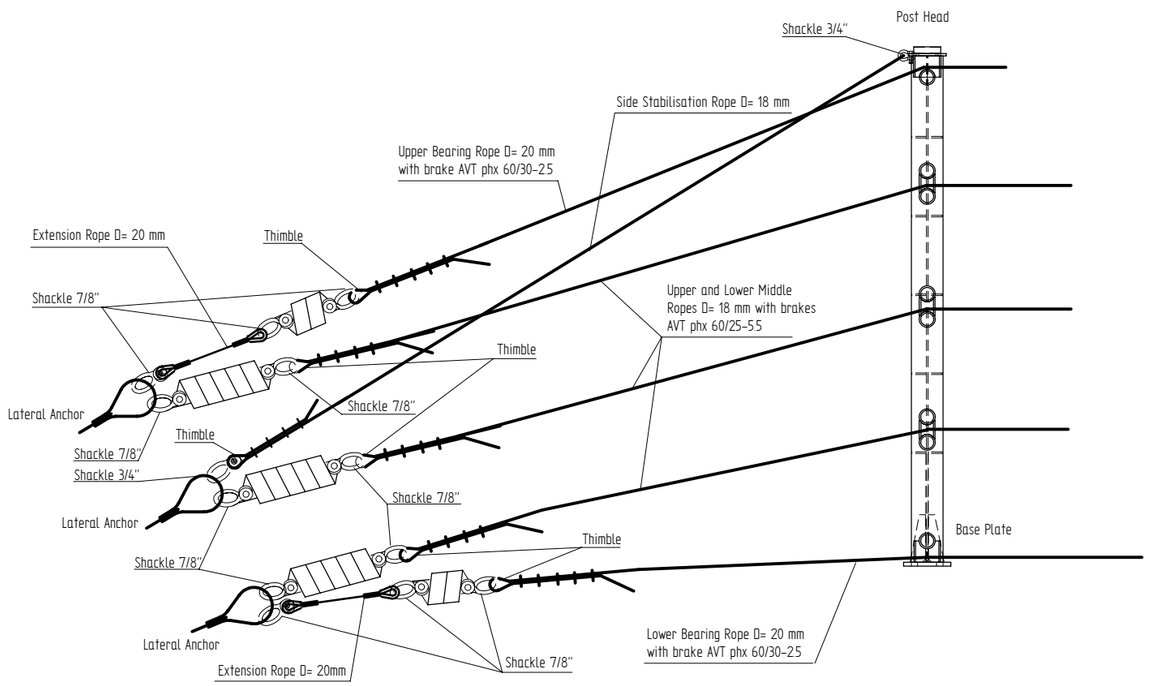

mf roll number	rev no	date	particulars	dwn / chkd	appd

GLEN ACCESS ROAD
ROCK FALL PROTECTION
FENCE DETAILS FOR
TS-1000-oA

ONTARIO POWER GENERATION

Hydro-Thermal Operations
Niagara Plant Group

dwn AB	designed by AB	FOR ORIGINAL SIGNATURES SEE REVISION 00.
chkd AB	design reviewed by AB	THIS DOCUMENT AND THE INFORMATION CONTAINED HEREIN IS THE EXCLUSIVE PROPERTY OF, AND IS CONFIDENTIAL AND PROPRIETARY TO, ONTARIO POWER GENERATION INC. ALL RIGHTS RESERVED. THIS DOCUMENT AND INFORMATION CONTAINED HEREIN MAY BE USED ONLY AS AUTHORIZED IN WRITING BY ONTARIO POWER GENERATION INC. AND MAY NOT BE REPRODUCED OR UTILIZED IN ANY FORM OR BY ANY MEANS, ELECTRONIC OR MECHANICAL, INCLUDING PHOTOCOPY RECORDING, OR BY ANY INFORMATION STORAGE OR RETRIEVAL SYSTEM AND MAY NOT BE DISCLOSED, IN WHOLE OR IN PART, WITHOUT THE PRIOR WRITTEN CONSENT OF ONTARIO POWER GENERATION INC.
date yr/month/day 2013.03.01	authorized by AB	
scale NTS	CAD file type DWG	

dwg no	dwg no	rev
	NF20-D3E-14100-0002	00

CLASS NI

A3 (297 x 420)